

√ 162.953m √ 162.849m

200 Year Level

LONGITUDINAL-SECTION

B-B


Maintenance Track

3.5m

Reproduced by permission of the Ordnance Survey on behalf of HMSO. (C) Crown Copyright and database right 2013. All rights reserved. Ordnance Survey Licence Number: 100046668 Maintenance Track

Existing Ground Level

Permanent Pool Level

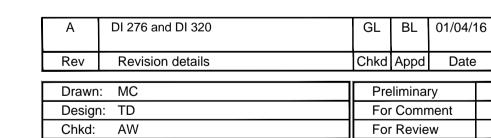

Drawn:	MC		Preliminary	
Design:	TD		For Comment	
Chkd:	AW		For Review	
Appd:	GM		For Construction	\checkmark
Date:	09-09-2014		As Constructed	
			Other	
				_
		V 1818		





Project Name

M8 M73 M74 MOTORWAY **IMPROVEMENTS**

Drawing Title

DRAINAGE OUTFALL Section 2.3 - Outfall 3 - Sections

Original Drawing Size: A1	Dimensions: Metres
Scale: 1:500	Copyright © Amey

	o op yg o /o y	
Drawing No		Rev
CO21000101/052	0/028	Α